

ROBERT T.
LAWRENCE, JR.,
ARCHITECT &
ASSOCIATES
Joseph T. Lawrence, Architect, Associate
Regina A. Lawrence, Architect, Associate
1000 Main Street, Suite 200
Birmingham, Tennessee 37603-5422
Phone: 615-426-2671

J. P. THOMAS
& ASSOCIATES, INC.
Civil Engineer
A

JAMNU H. TAHILANI
& ASSOCIATES, INC.
Structural Engineer
A

GAIA ENGINEERING
Mechanical Engineer
A


BURNS ENGINEERING
Structural Engineer
A


30 JULY 2011
NEW WINDOZE
ELEMENTARY SCHOOL
MEMPHIS CITY SCHOOLS
PROJECT #10000
3000 ROCKWAY ROAD
MEMPHIS, TENNESSEE

RECORD SET


Drawn: J. P. THOMAS
Checked: J. P. THOMAS
Title: NEW WINDOZE
Date: 07/30/11


A1.1

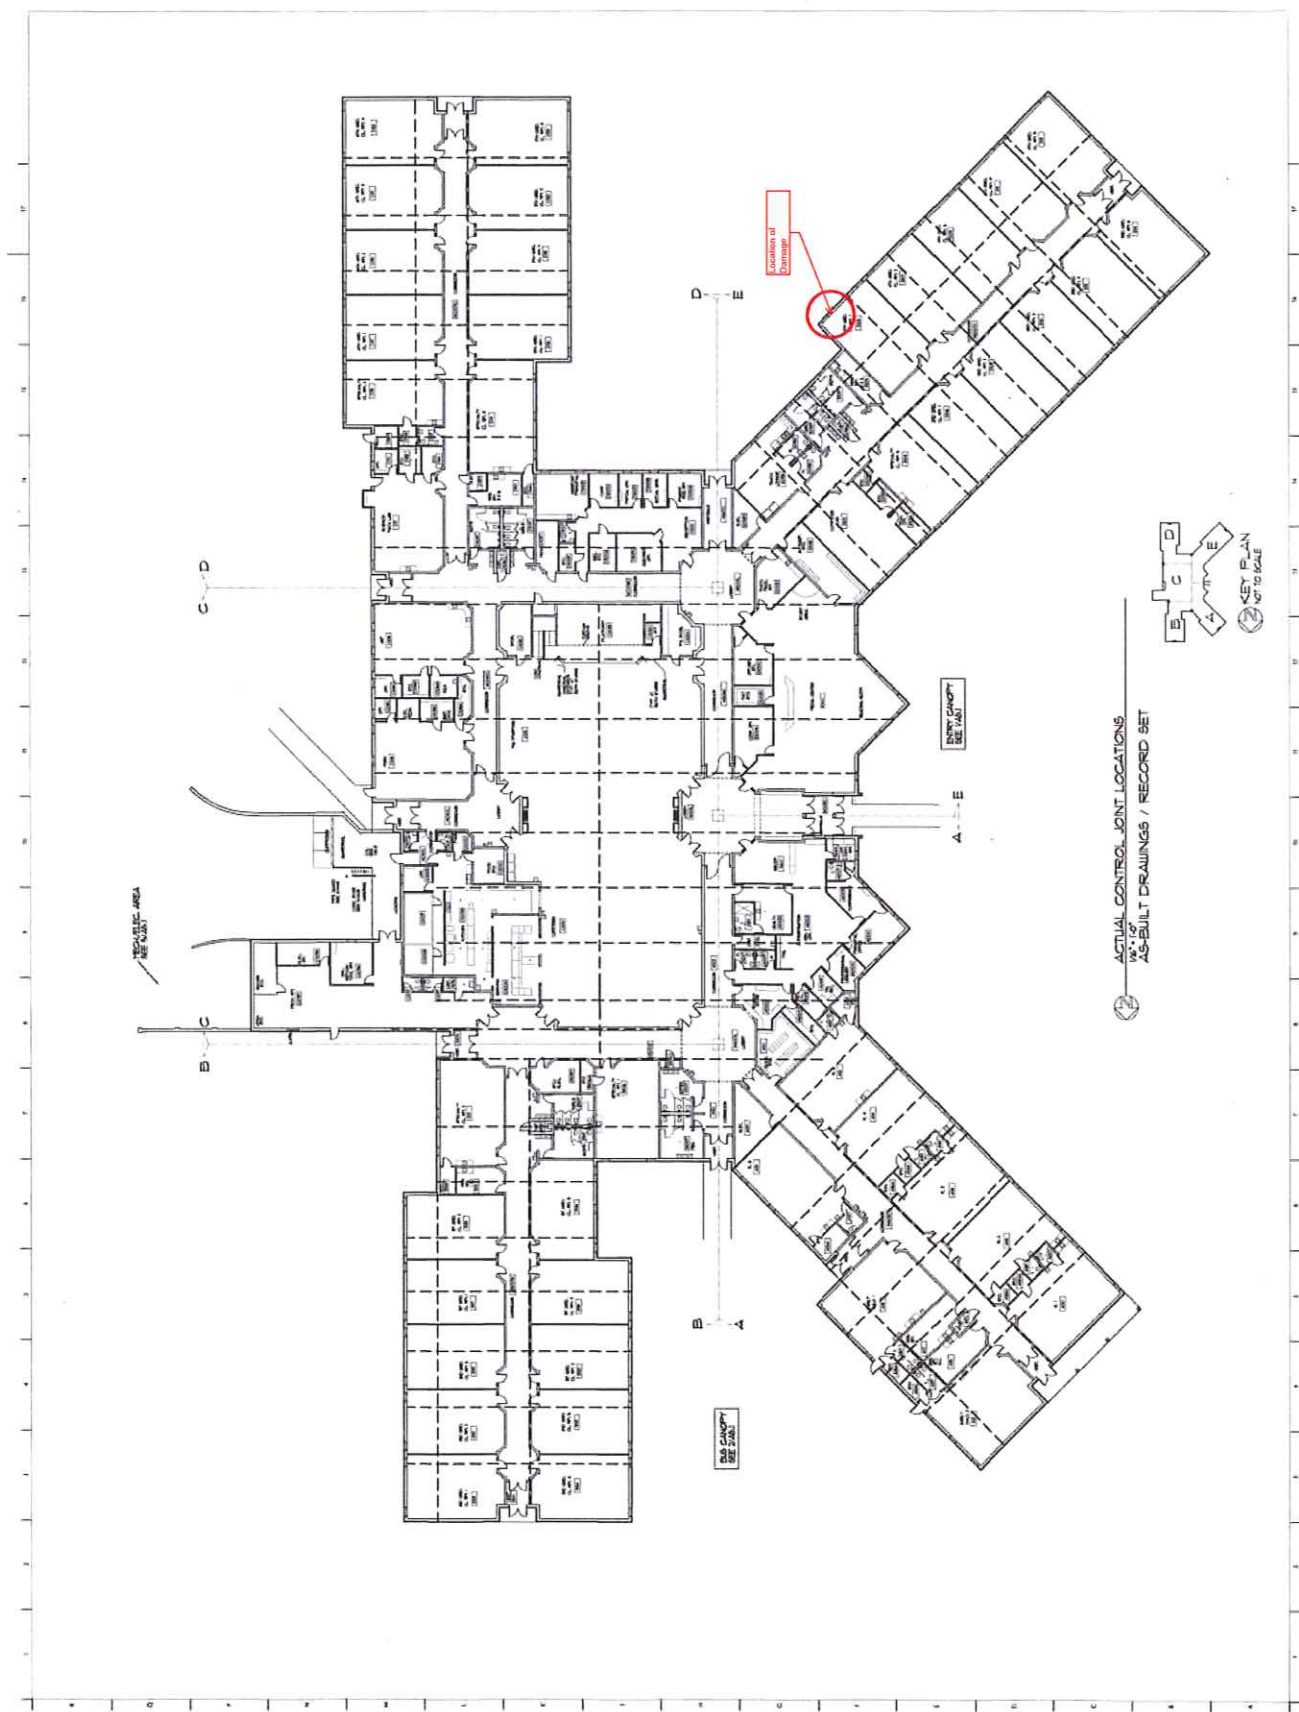

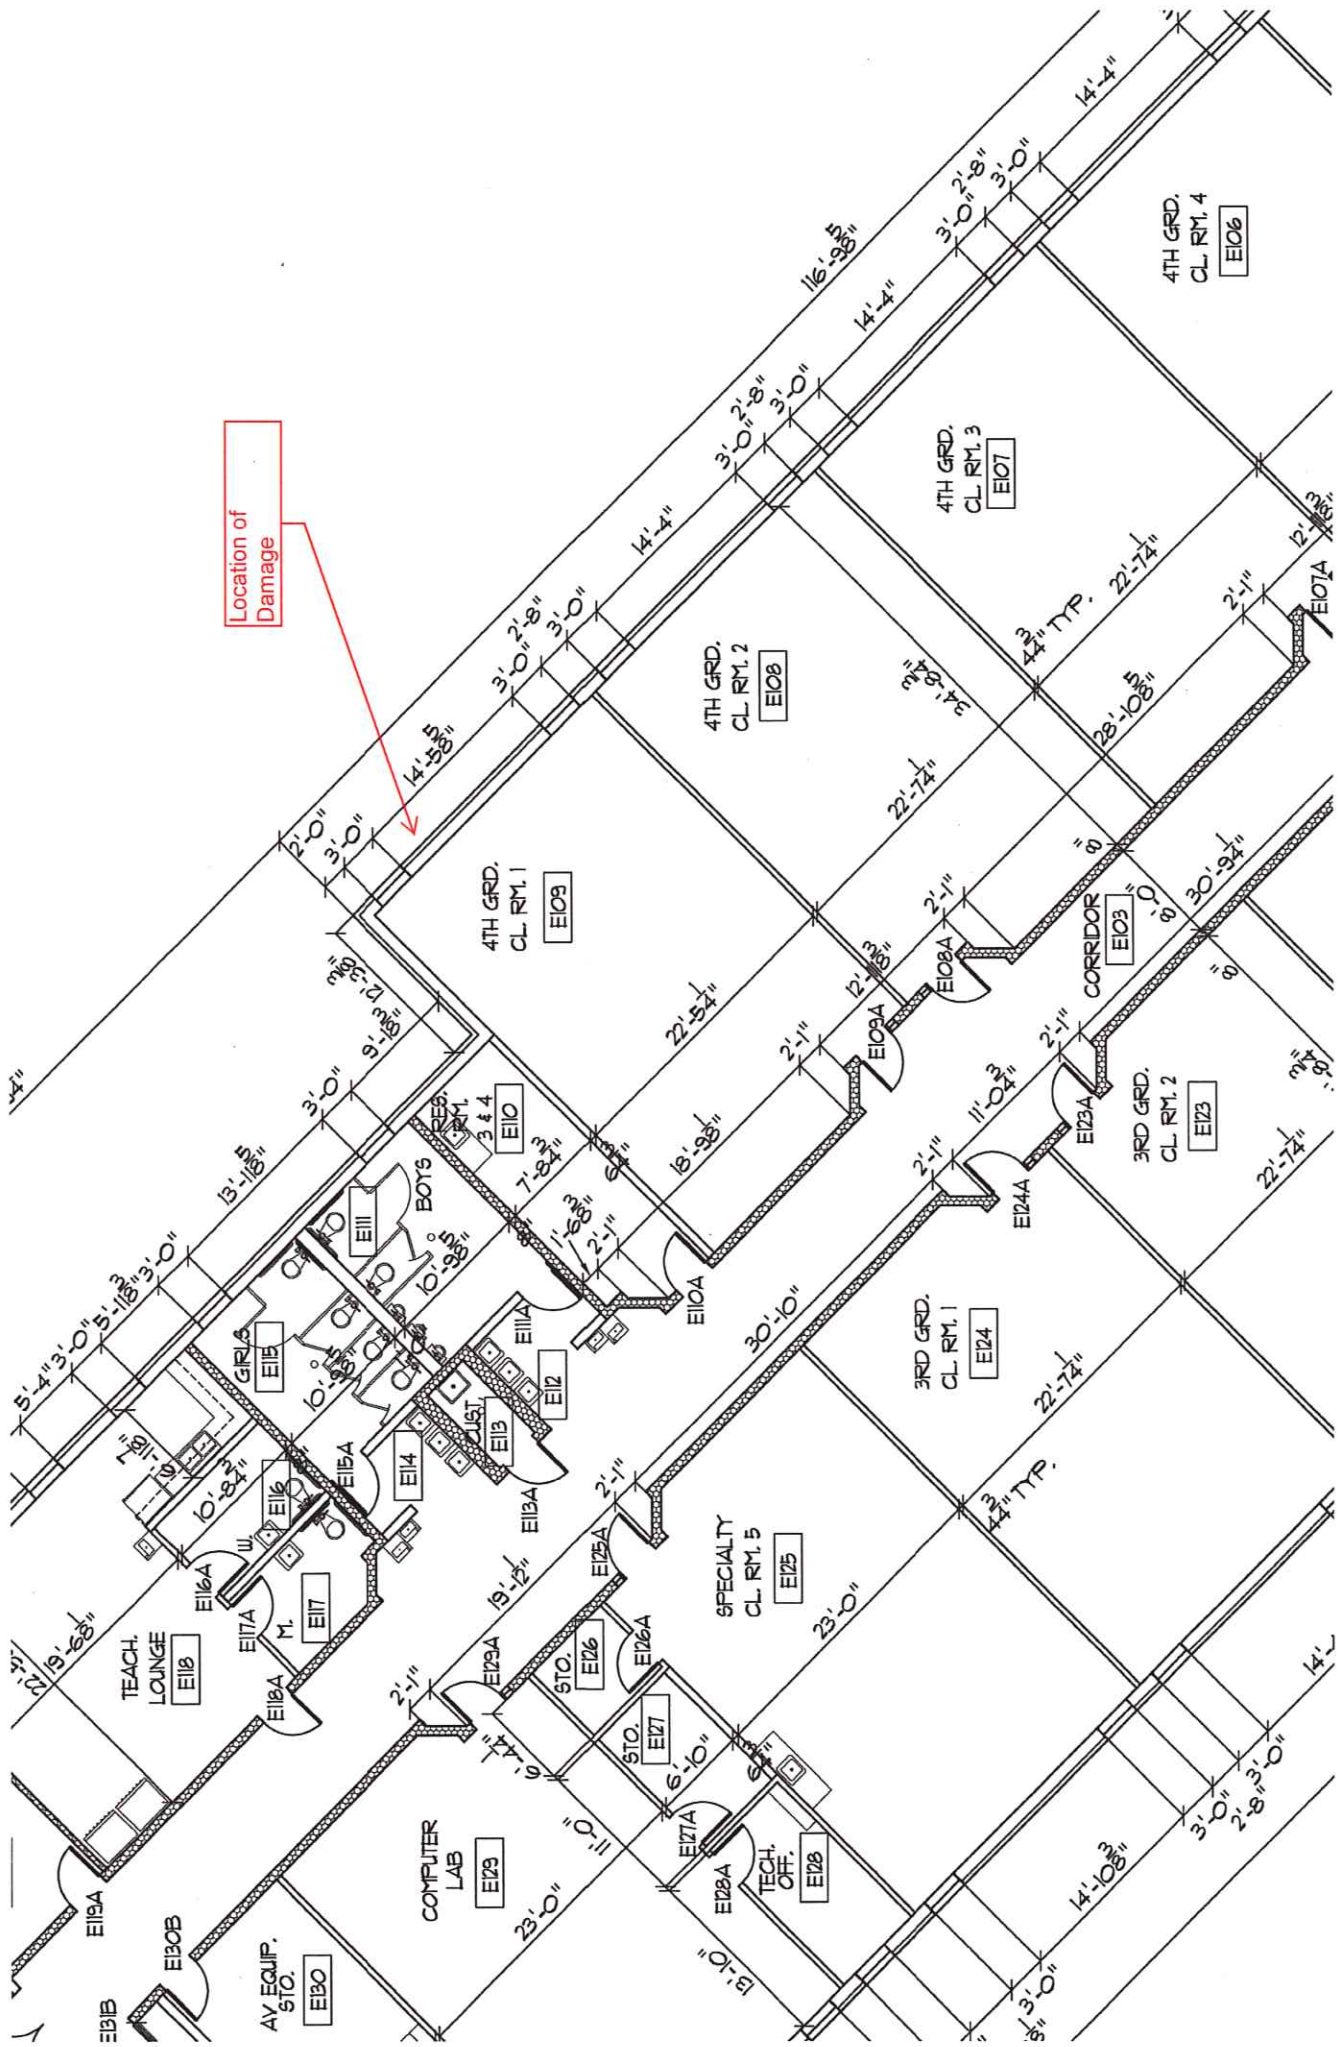



Location of Damage

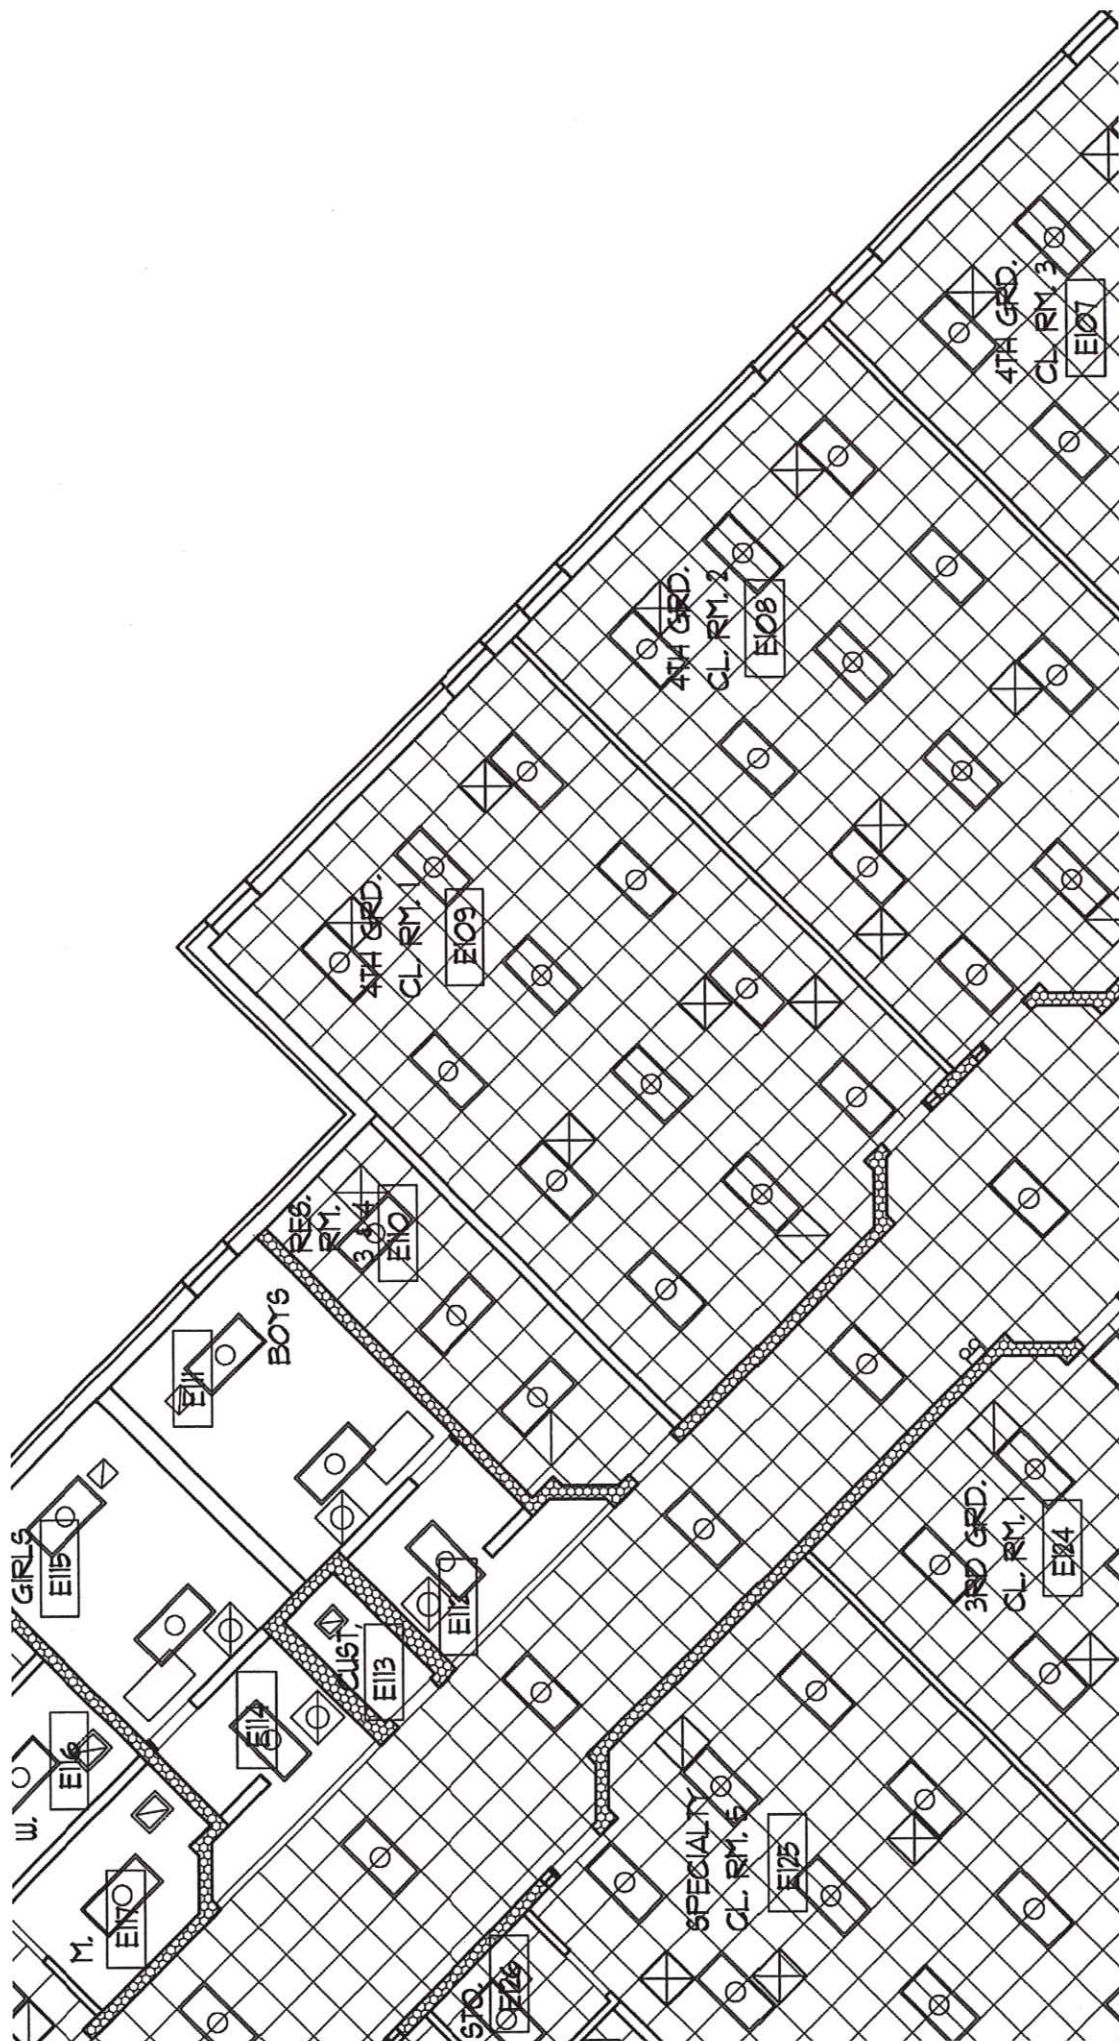

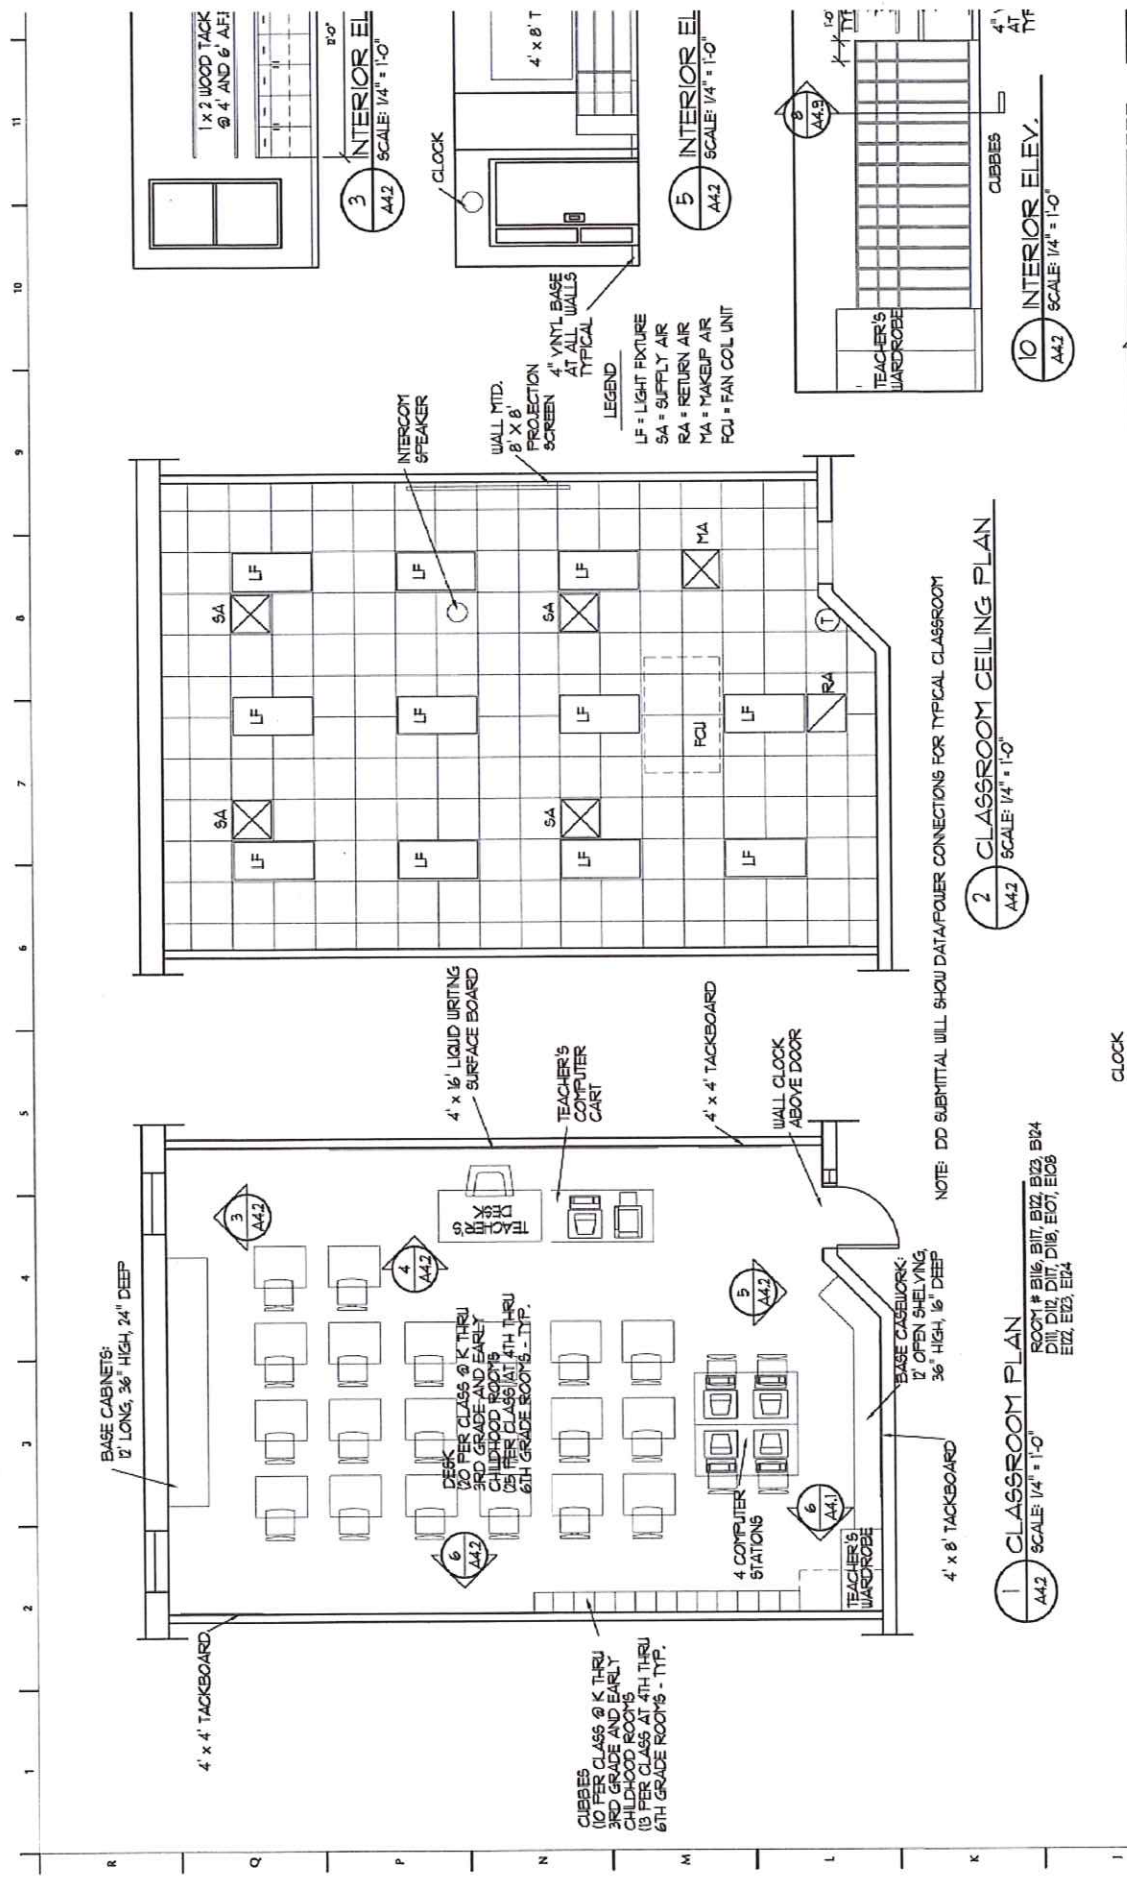

CLOCK

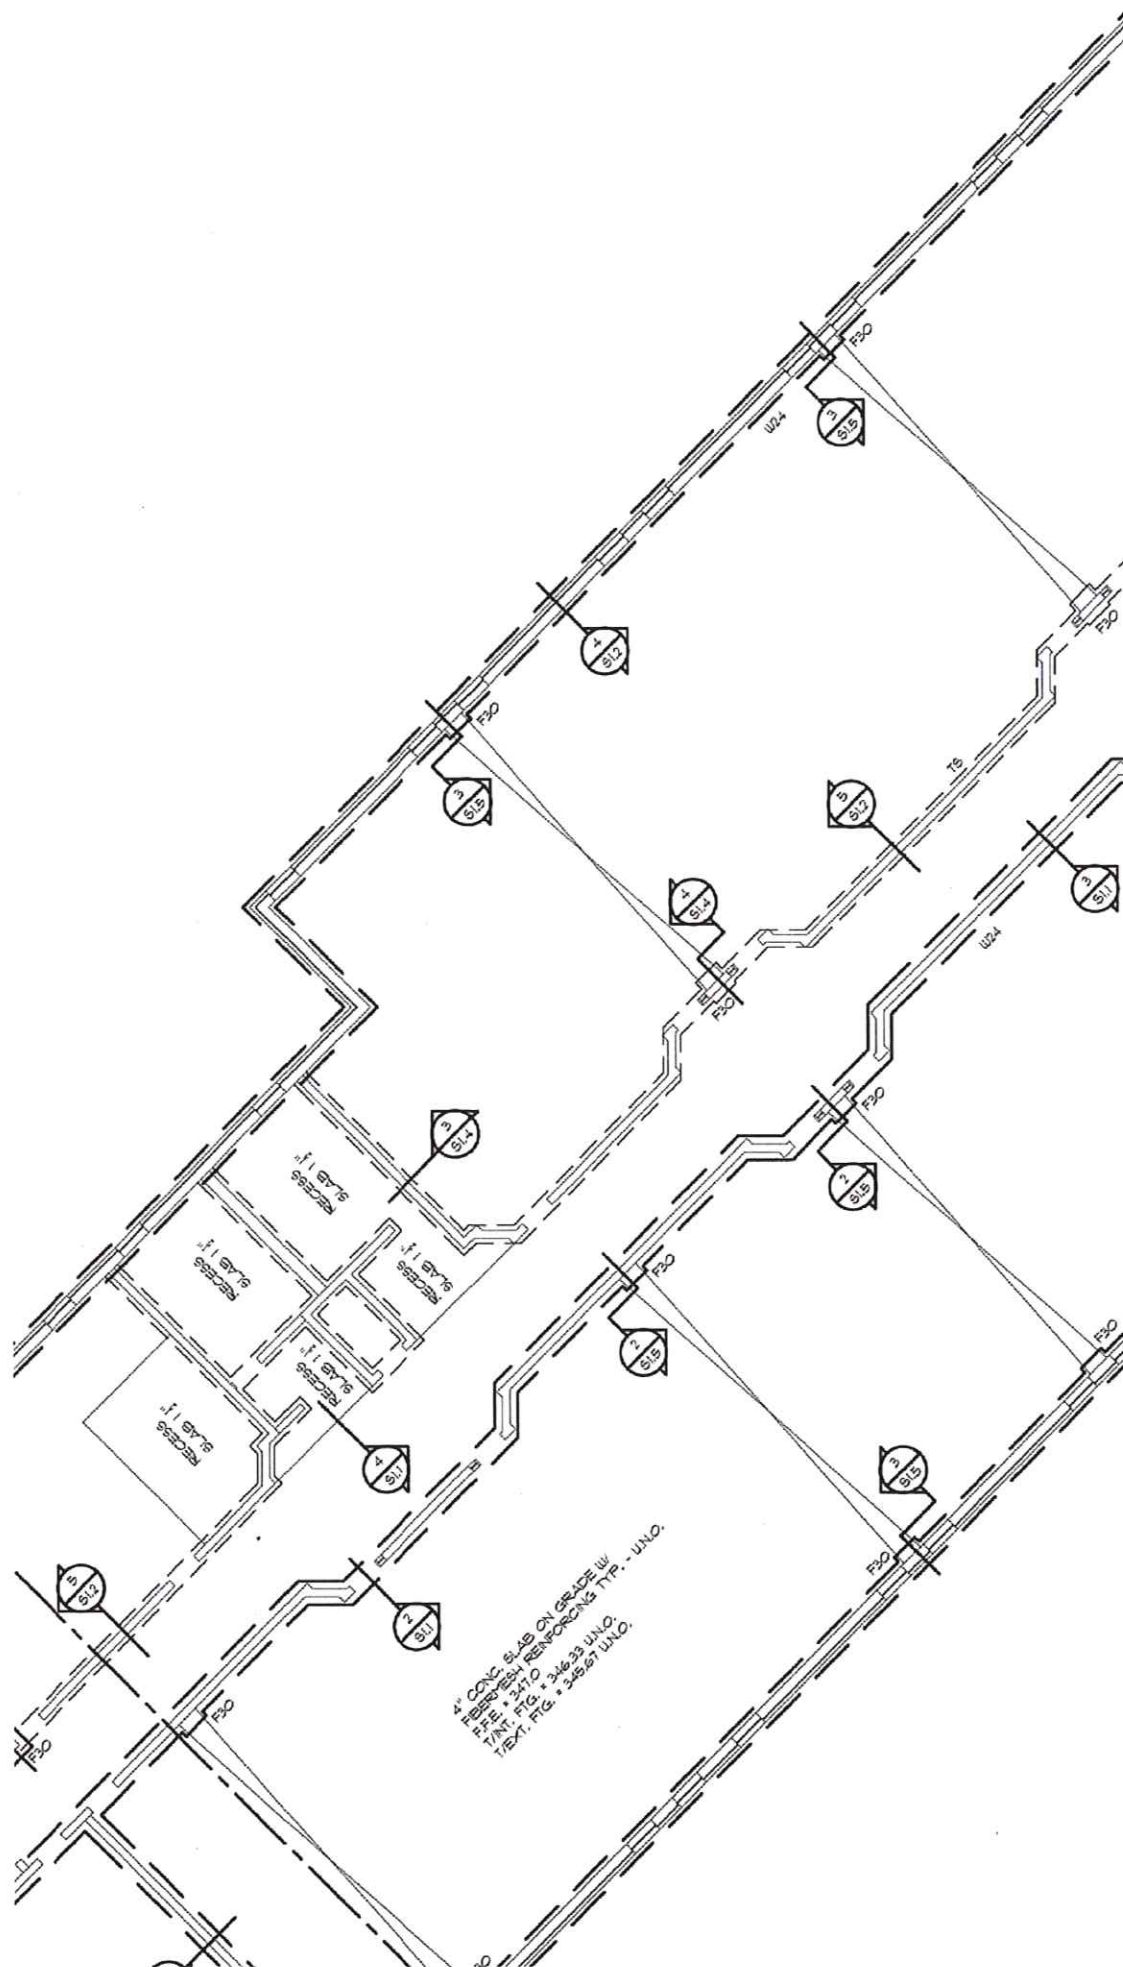

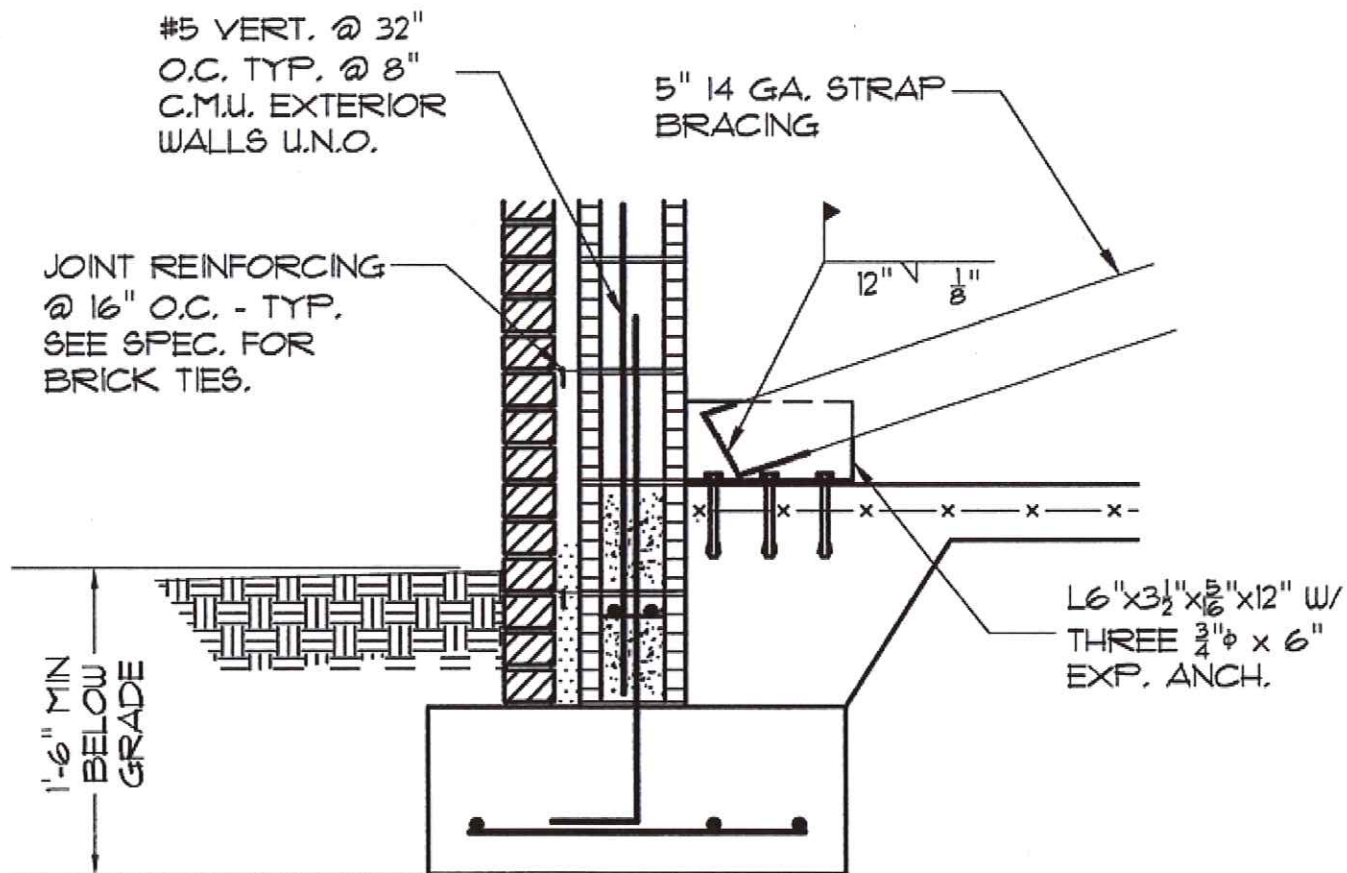

3 FOUNDATION SECTION
SCALE: 3/4" = 1'-0"

ROBERT T.
LAURENCE, JR.,
ARCHITECT &
ASSOCIATES
1000 South Orange Drive, Suite 2
Nashville, Tennessee 37203-3405
Phone: 615-485-1415

J. P. THOMAS
& ASSOCIATES, INC.
Civil Engineers
1000 South Orange Drive, Suite 2
Nashville, Tennessee 37203-3405
Phone: 615-485-1415

JAMM H. TAHLIANI
& ASSOCIATES, INC.
Structural Engineers
1000 South Orange Drive, Suite 2
Nashville, Tennessee 37203-3405
Phone: 615-485-1415

GALA ENGINEERING
Mechanical Engineers
1000 South Orange Drive, Suite 2
Nashville, Tennessee 37203-3405
Phone: 615-485-1415


BURNS ENGINEERING
Electrical Engineers
1000 South Orange Drive, Suite 2
Nashville, Tennessee 37203-3405
Phone: 615-485-1415

RELIANCE
ELEMENTARY SCHOOL
MEMPHIS CITY SCHOOLS
PARSONS BLVD
3000 REGENT ROAD
MEMPHIS, TENNESSEE


CONSTRUCTION DOCUMENTS
ROOF FRAMING PLAN AREA

ADDITIONAL DRAWINGS
1. ROOF FRAMING PLAN AREA
2. ROOF FRAMING SECTION A-A
3. ROOF FRAMING SECTION B-B
4. ROOF FRAMING SECTION C-C
5. ROOF FRAMING SECTION D-D
6. ROOF FRAMING SECTION E-E
7. ROOF FRAMING SECTION F-F
8. ROOF FRAMING SECTION G-G
9. ROOF FRAMING SECTION H-H
10. ROOF FRAMING SECTION I-I
11. ROOF FRAMING SECTION J-J
12. ROOF FRAMING SECTION K-K
13. ROOF FRAMING SECTION L-L
14. ROOF FRAMING SECTION M-M
15. ROOF FRAMING SECTION N-N
16. ROOF FRAMING SECTION O-O
17. ROOF FRAMING SECTION P-P
18. ROOF FRAMING SECTION Q-Q
19. ROOF FRAMING SECTION R-R
20. ROOF FRAMING SECTION S-S
21. ROOF FRAMING SECTION T-T
22. ROOF FRAMING SECTION U-U
23. ROOF FRAMING SECTION V-V
24. ROOF FRAMING SECTION W-W
25. ROOF FRAMING SECTION X-X
26. ROOF FRAMING SECTION Y-Y
27. ROOF FRAMING SECTION Z-Z


Drawn: [Name]
Checked: [Name]
Date: 9/15/00
Scale: 1/8" = 1'-0"

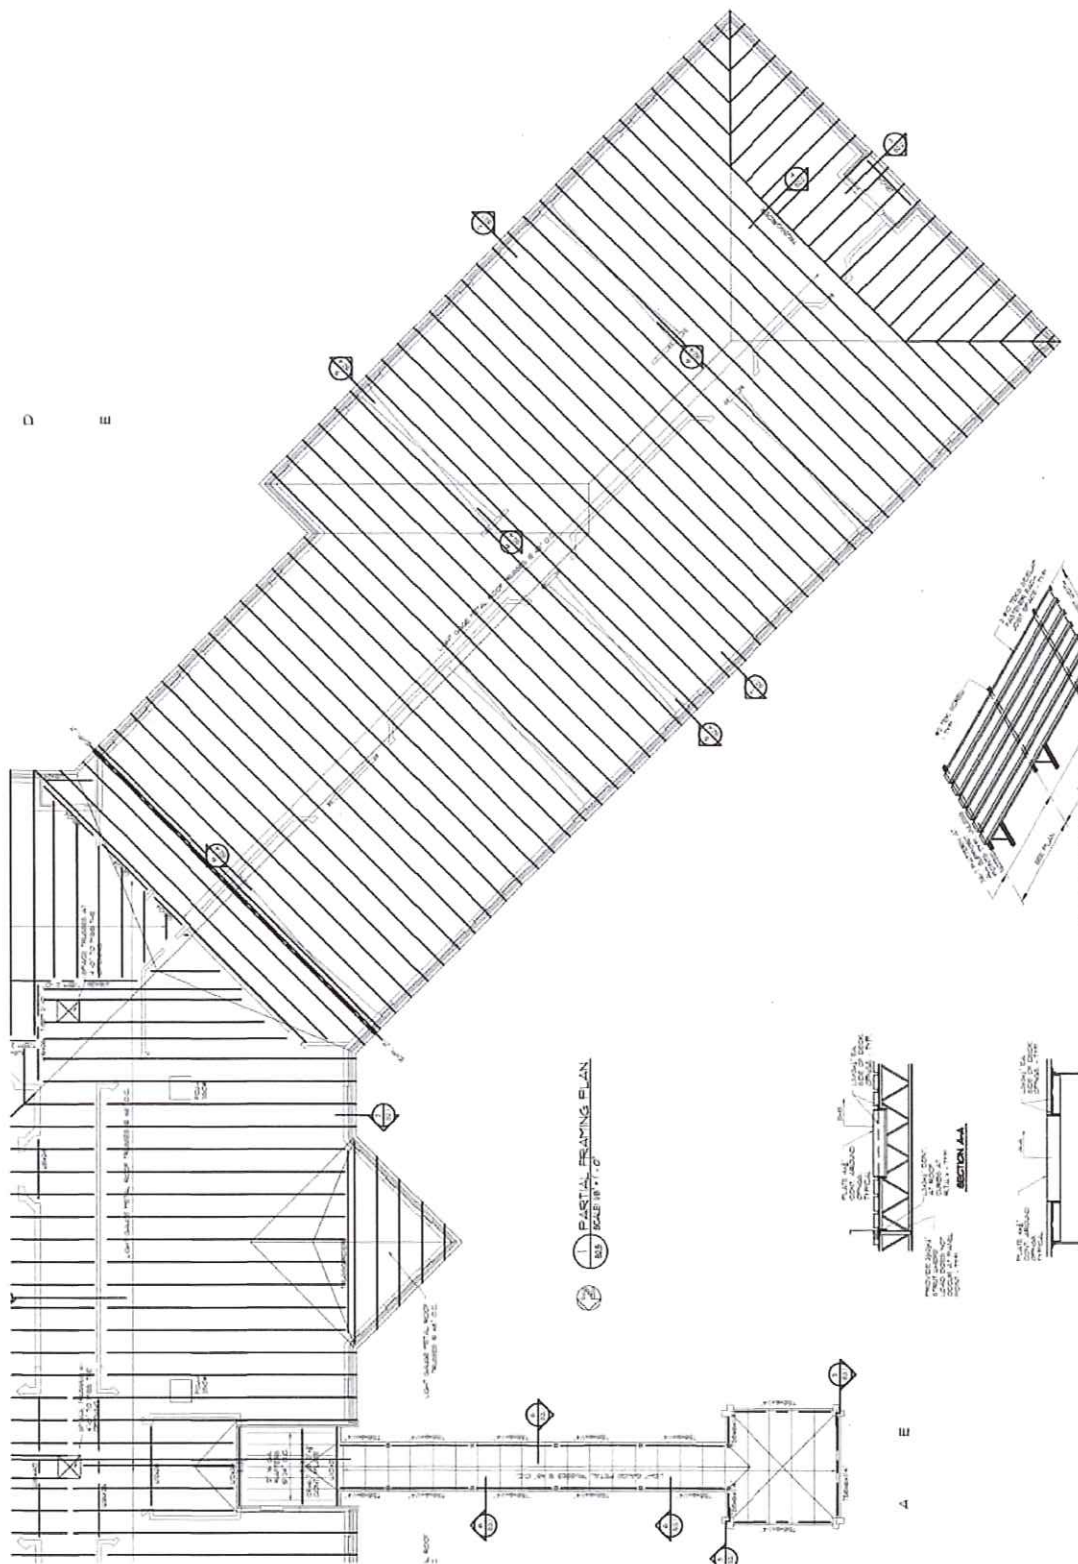


1. PARTIAL FRAMING PLAN
SCALE 1/8" = 1'-0"

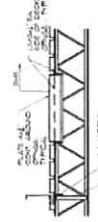

SECTION A-A

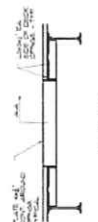

SECTION B-B

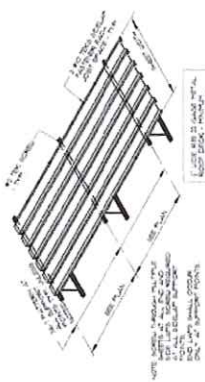

TYPICAL ROOF DECK TO JOIST CONNECTION DETAIL

TYPICAL ROOF OPENING DETAIL